


LEGEND

- STROBE, 75 cd
- STROBE, STANDARD
- STROBE, 15/75 cd
- BELL/STROBE COMBINATION 15/75
- CEILING MOUNTED STROBE, CANDELA AS NOTED
- MANUAL STATION
- BELL (E)
- SMOKE DETECTOR D = DUCT DETECTOR
- HEAT DETECTOR (E)
- JUNCTION BOX
- EXISTING
- NEW

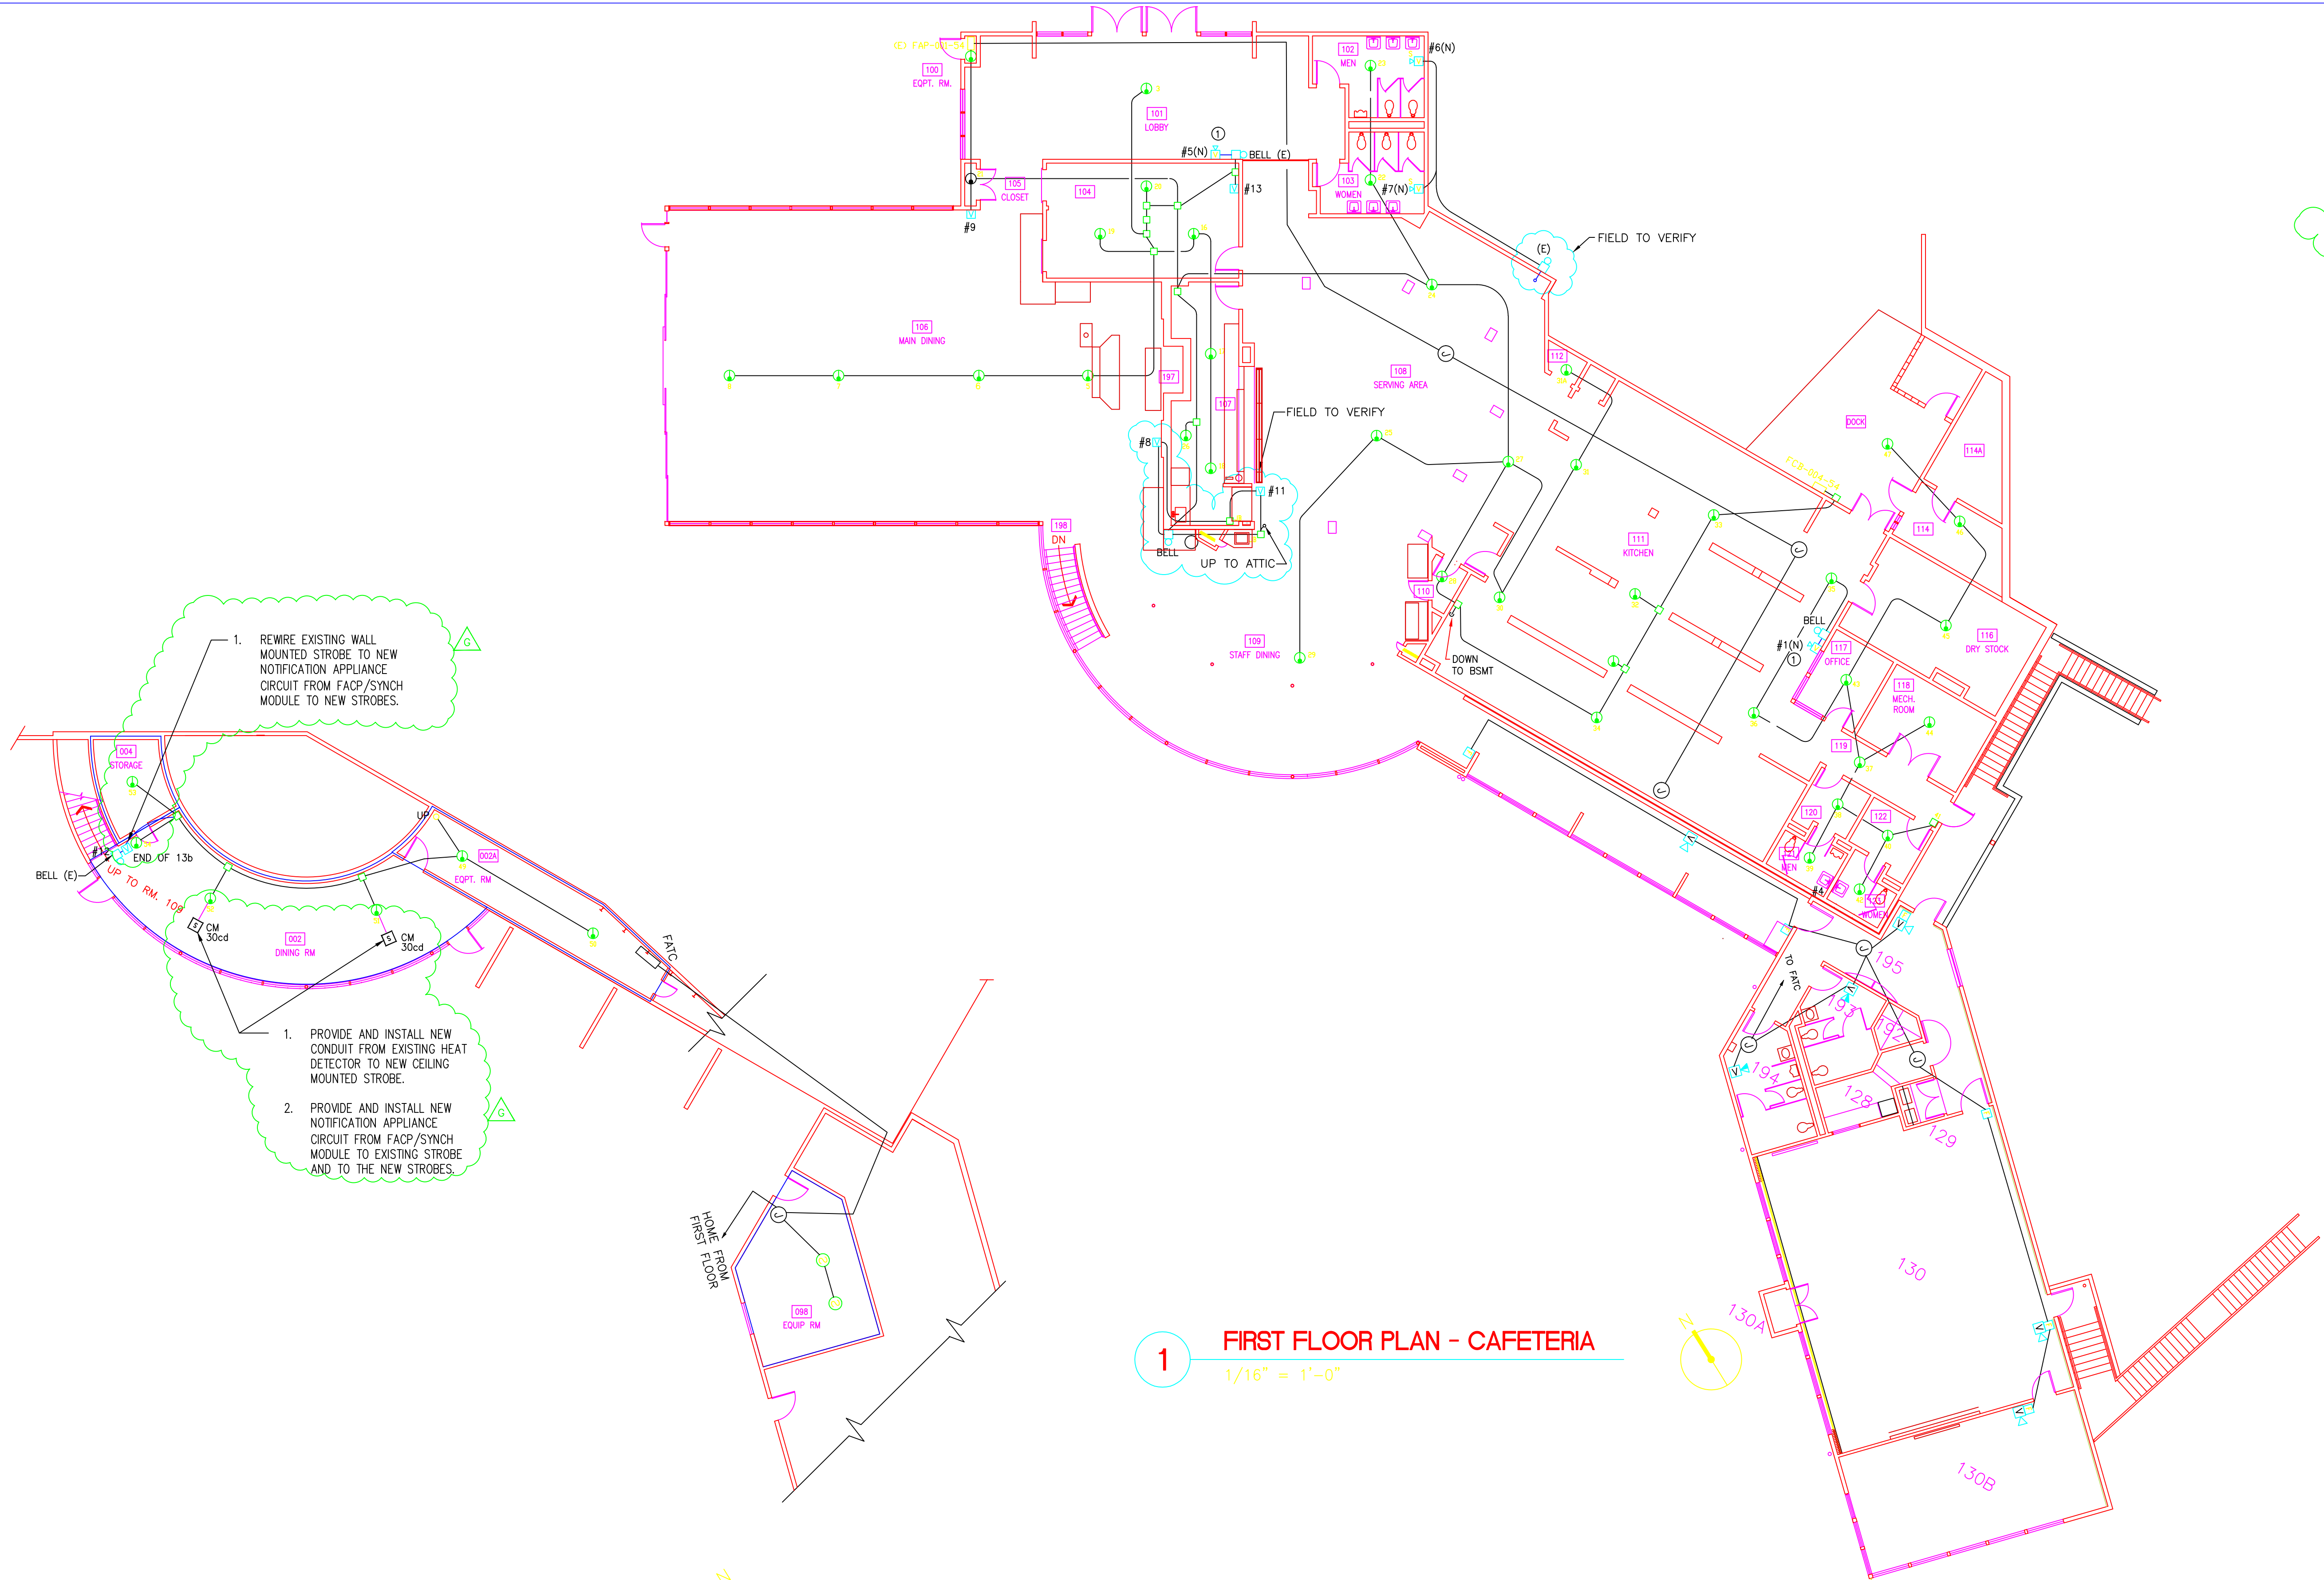

1 FIRST FLOOR PLAN - CAFETERIA  
1/16" = 1'-0"

2 BASEMENT FLOOR PLAN - CAFETERIA  
1/16" = 1'-0"

G	HYT	HYT	-	3/8/11	NEW STROBES IN BASEMENT DINING AREA
F	ROB	MCG	MCG	9/25/97	AS BUILT-CAFETERIA ADDITION
E	L.M.	M.G.	M.G.	2/21/97	AS BUILT-CAFE. EXTENSION PROJECT
D	V.V.	G.W.	M.G.	4/2/96	REDRAWN IN CAD & ADDED STROBES
C	R.G.			10/26/92	ADDED SPRINKLER RISER
B	L.S.R.	R.G.		1/7/86	REDRAWN
A	L.S.R.			11/85	AS-BUILT
REVISION NUMBER	DRAWN BY	CHECKED BY	APPR'D BY	DATE	REMARKS

54 CAFETERIA  
FIRE ALARM MODIFICATIONS  
PLANS

UNIVERSITY OF CALIFORNIA LAWRENCE BERKELEY LABORATORY  
FACILITIES DEPARTMENT

DRAWN BY	PL	DATE	02/26/11
CHECKED BY	GW		/ /
APPROVED BY	MCG		/ /
CAD FILE PATH	00002672		
SCALE	As Noted		
DRAWING NO.	4B54E012G	SHEET	FA1.
PROJECT NO.	TBD		1 OF 1